




LAND INFORMATION SERVICES, INC.  
ENGINEERS, SURVEYORS & CONSULTANTS  
9723 WATERTOWN PLANK ROAD  
BUILDING 54  
WAUKESHA, WI 53186  
TEL: 414-251-7444 FAX: 414-251-9114

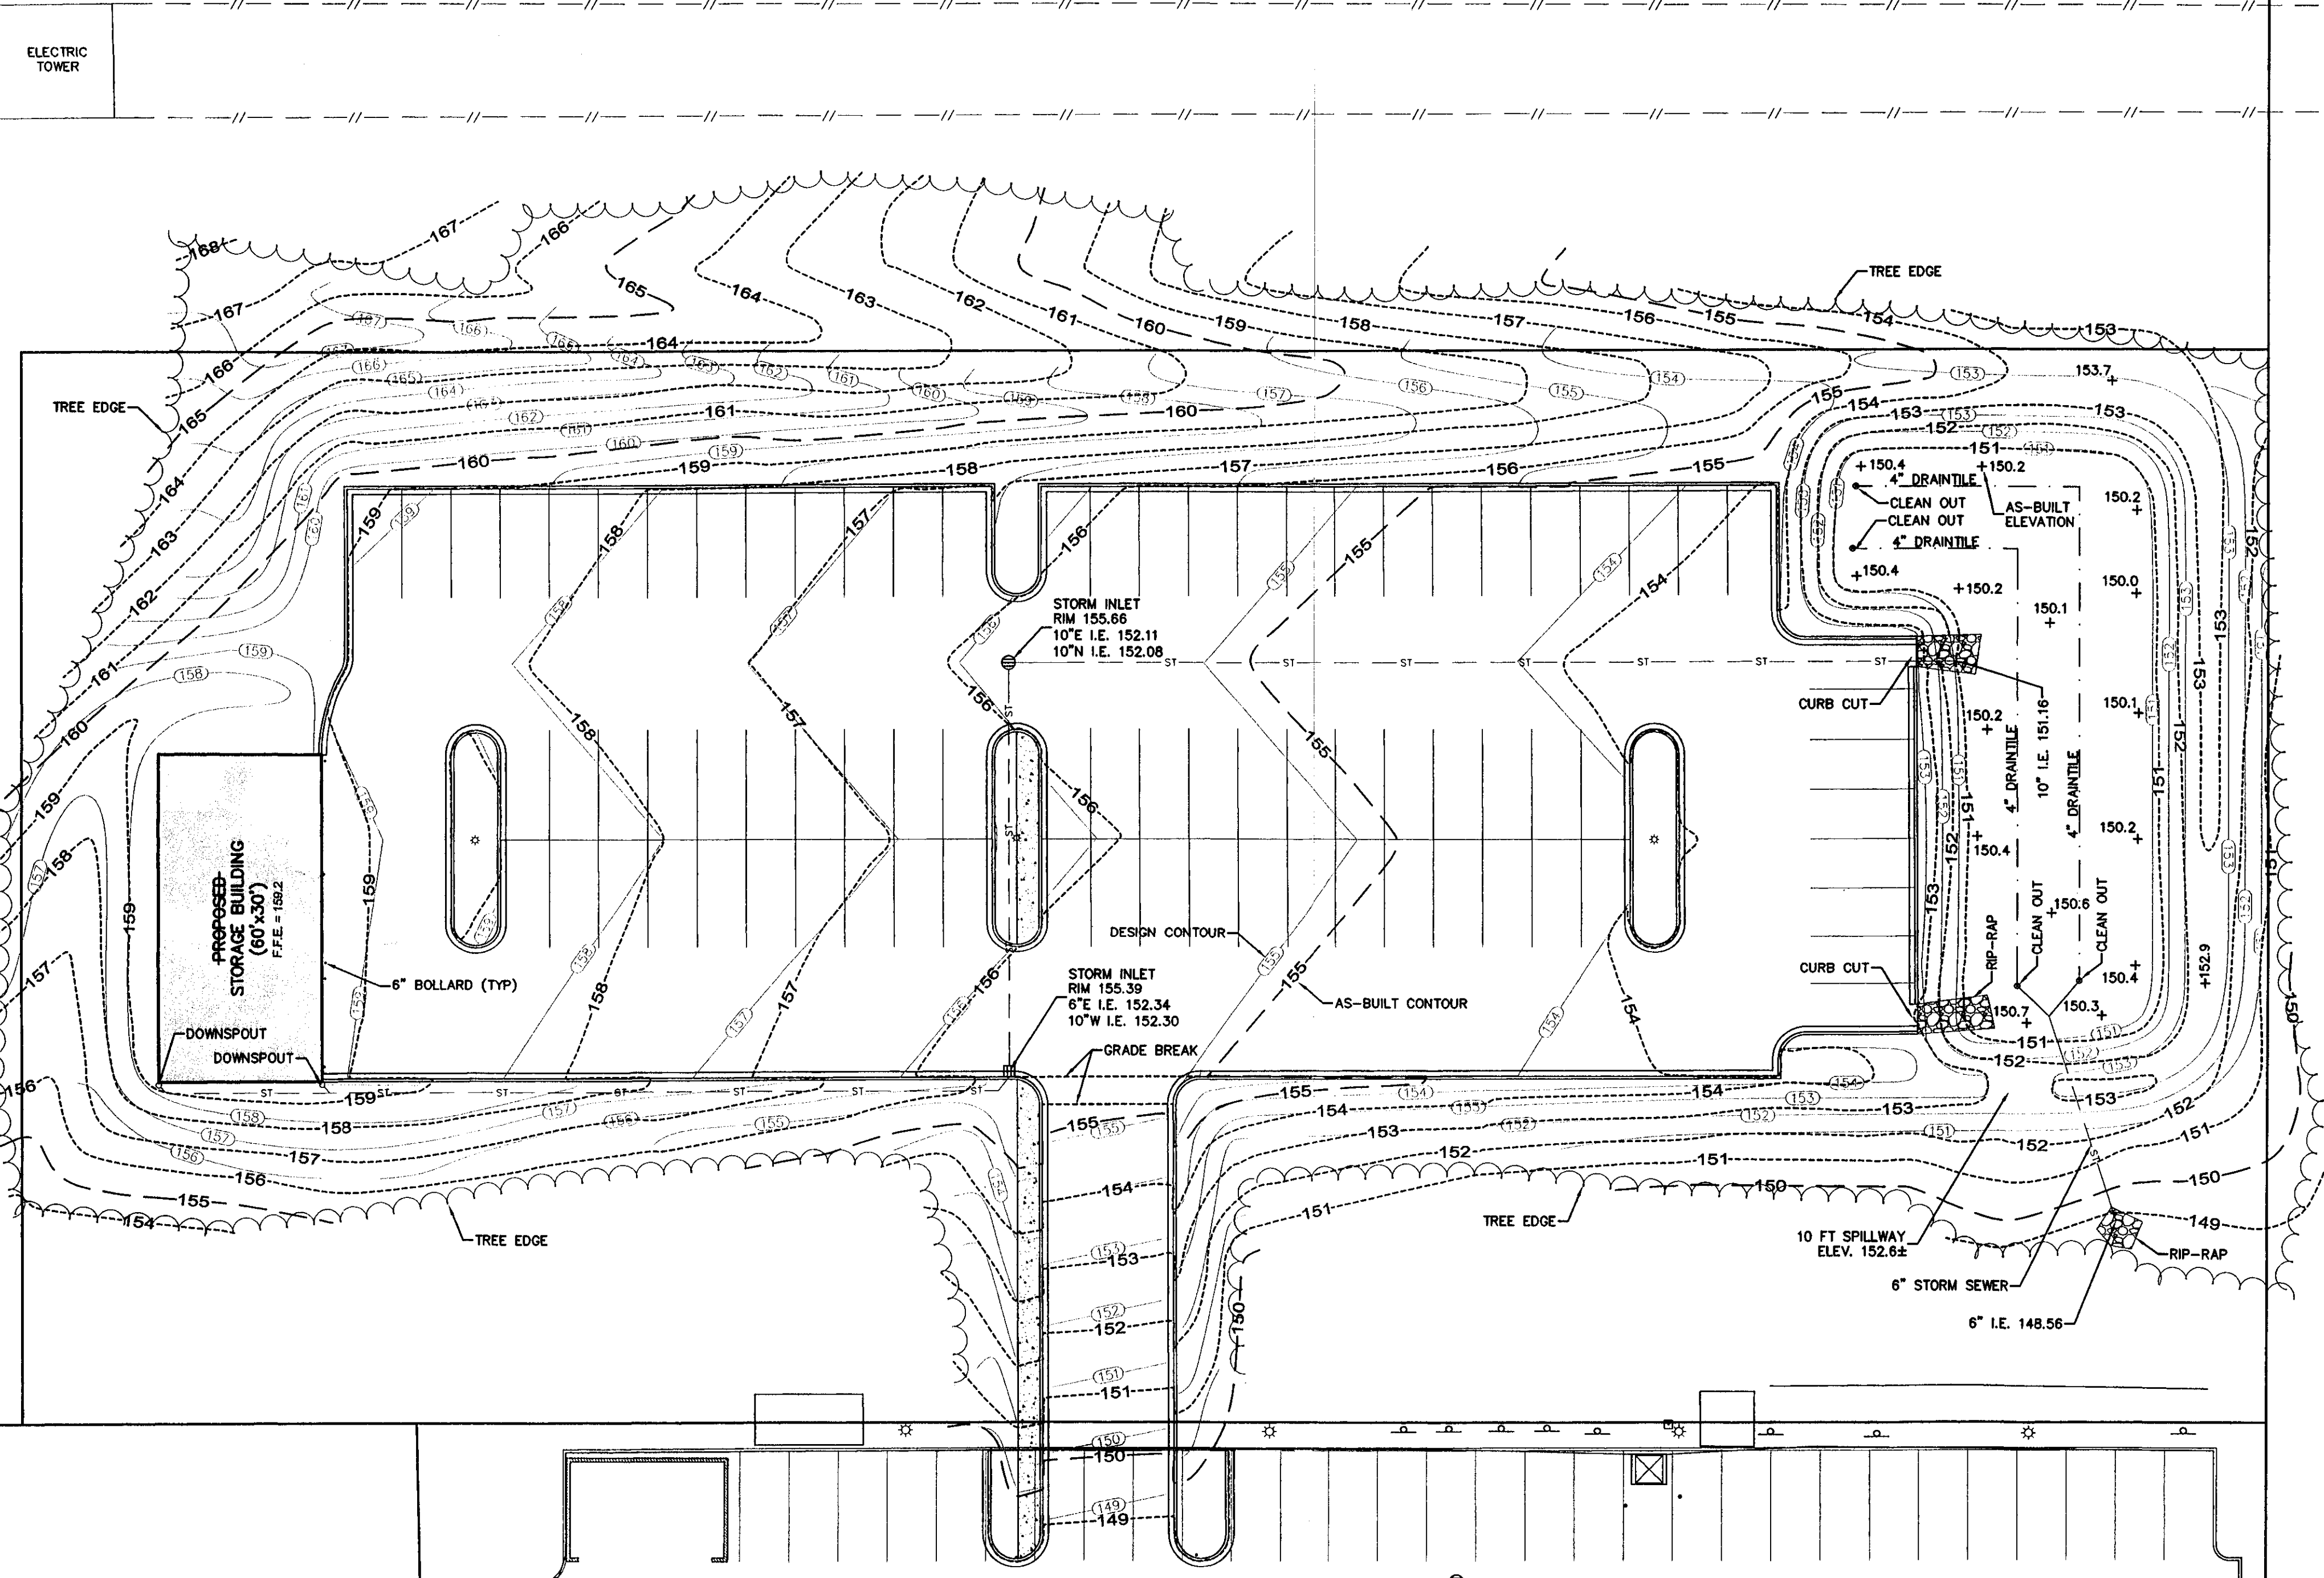


ROOT RIVER PARKWAY

SATURN  
DEALERSHIP

VICI CAPILLI  
SOUTH CAMPUS

EXISTING BUILDING

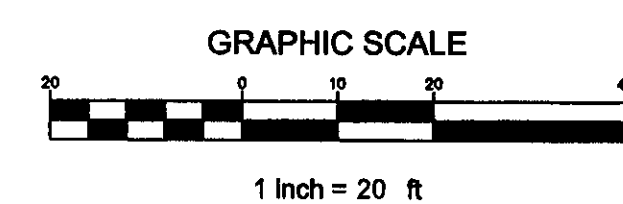


TO OBTAIN LOCATION OF  
PROPERTY SHOWN (YOU  
DO NOT OWN IT)  
CALL DIGGERS HOTLINE  
1-800-242-8911  
TOLL FREE  
WIS. STATUTE 107.02(1)(2)(3)  
NOTICE BEFORE YOU DIGGATE  
M.W. AREA 259-1181

THE LOCATION OF EXISTING UTILITY INSTALLATIONS AS  
SHOWN ON THIS DRAWING IS APPROXIMATE AND  
BASED ON RECORD DRAWINGS, FIELD SURVEY AND  
NOT A GUARANTEE OF ACCURACY OF WHICH YOU  
SHOULD BE AWARE.

LEGEND	
<ul style="list-style-type: none"> <li>○ BASKETBALL HOOP (BH)</li> <li>● BENCHMARK (BM)</li> <li>○ BOLLARD (BO)</li> <li>○ BUSH, SHRUB, ETC.</li> <li>○ CATCH BASIN ROUND (CB)</li> <li>○ CATCH BASIN SQUARE (CS)</li> <li>○ CLEAN OUT (CO)</li> <li>○ CURB INLET (CI)</li> <li>○ EVERGREEN TREE (ET)</li> <li>○ FIRE HYDRANT (HYD)</li> <li>○ FLAG POLE (FP)</li> <li>○ GUY WIRE (GW)</li> <li>○ HANDICAP</li> <li>○ IRON PIPE (I.P.)</li> <li>○ LIGHT POLE</li> <li>○ MAIL BOX (MB)</li> <li>○ MANHOLE (MH)</li> <li>○ MONITORING WELL (MW)</li> <li>○ SIGN (TRAFFIC, ETC.)</li> <li>○ SOIL BORING (SB)</li> <li>○ TRAFFIC LIGHT (TL)</li> <li>○ DECIDUOUS TREE (TR)</li> <li>○ UTILITY MARKER</li> <li>○ UTILITY METER</li> <li>○ UTILITY PEDESTAL</li> <li>○ UTILITY POLE (UP)</li> <li>○ UTILITY VALVE</li> <li>○ WATER WELL</li> </ul>	<ul style="list-style-type: none"> <li>○ METAL FENCE</li> <li>○ WOOD FENCE</li> <li>○ GUARD RAIL</li> <li>○ UNDERGROUND CABLE TV</li> <li>○ UNDERGROUND COMB.</li> <li>○ UNDERGROUND SEWER</li> <li>○ UNDERGROUND ELECTRIC</li> <li>○ GAS SERVICE</li> <li>○ OVERHEAD UTILITY LINES</li> <li>○ SANITARY SEWER</li> <li>○ STORM SEWER</li> <li>○ UNDERGROUND TELEPHONE</li> <li>○ WATER MAIN / SERVICE</li> <li>○ SANITARY FORCE MAIN</li> <li>○ TREE LINE</li> </ul>

SITE GRADING & STORMWATER BASIN AS-BUILT  
**VICI AVEDA INSTITUTE  
PARKING LOT EXPANSION**  
4111 S. 108TH STREET, GREENFIELD, WI

DRAWN BY: N.G.K.  
CHECKED BY: M.A.B.  
DATE: 08/08/07  
JOB NUMBER: S05182R0AS

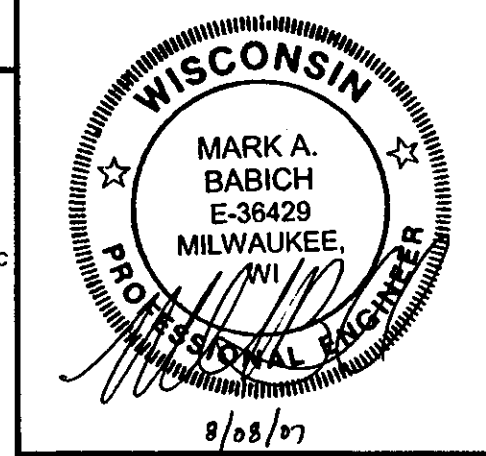

8-386  
VICI AS-BUILT