
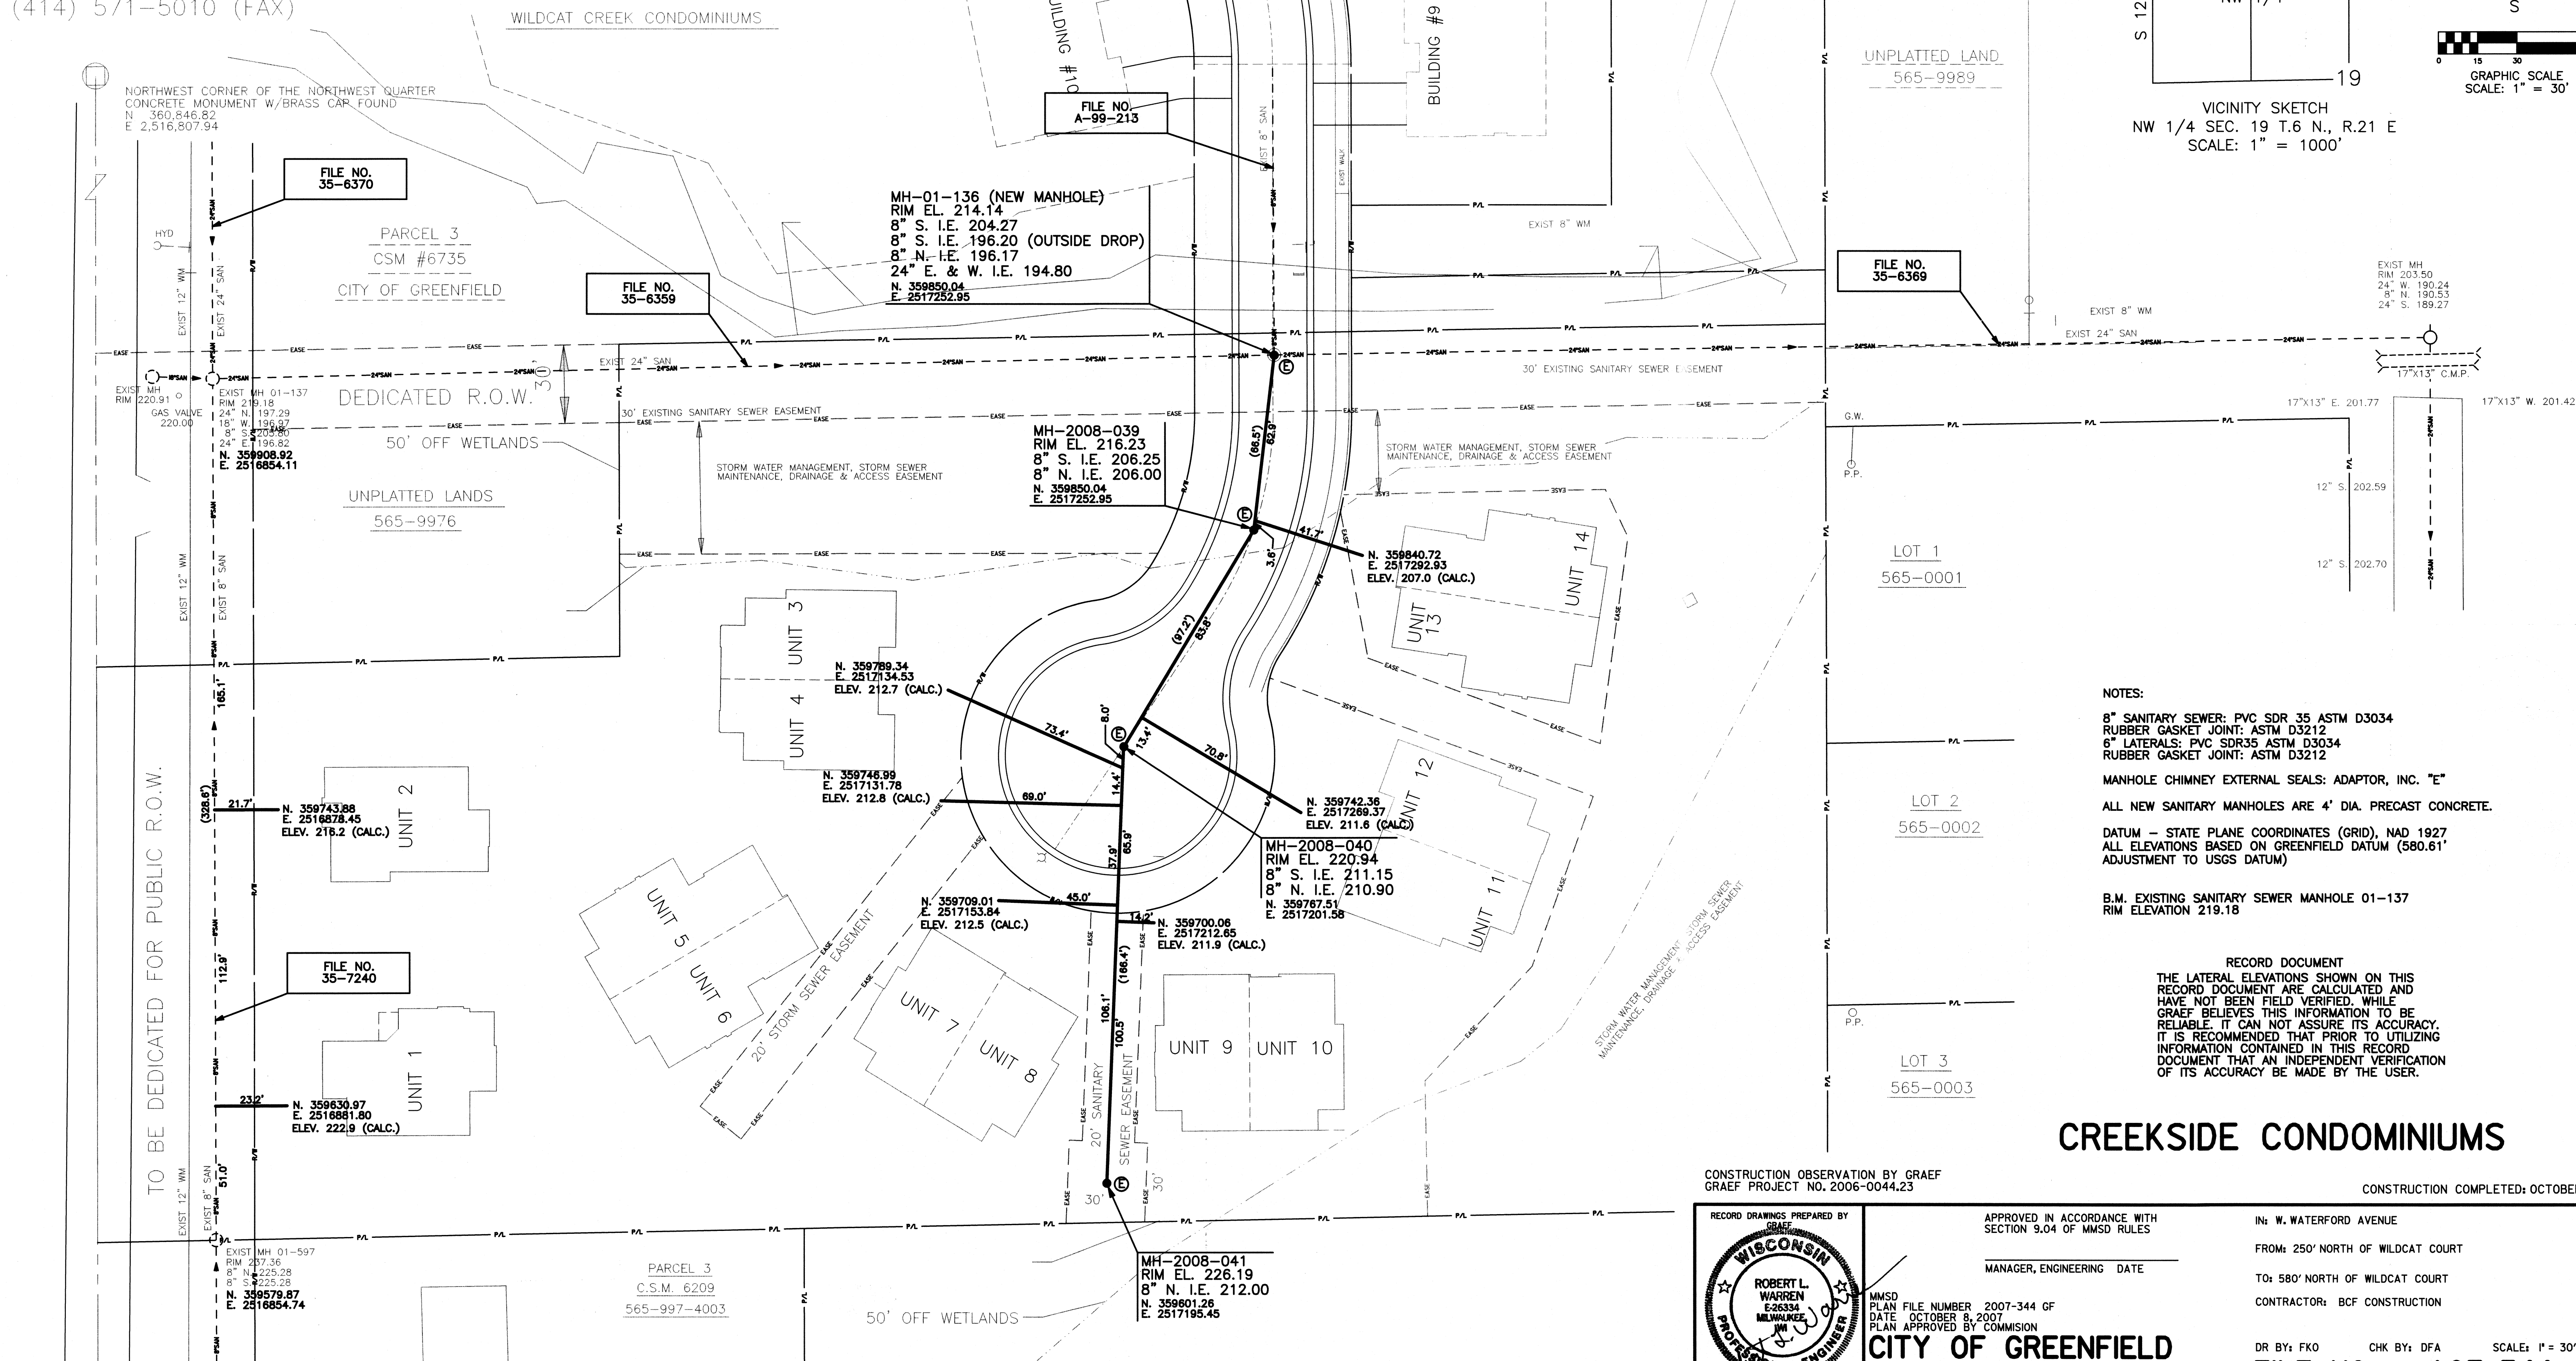


OWNER:
GENESIS CONSTRUCTION
2211 S. 10TH AVENUE
SOUTH MILWAUKEE, WISCONSIN 53172
(414) 571-5011
(414) 571-5010 (FAX)

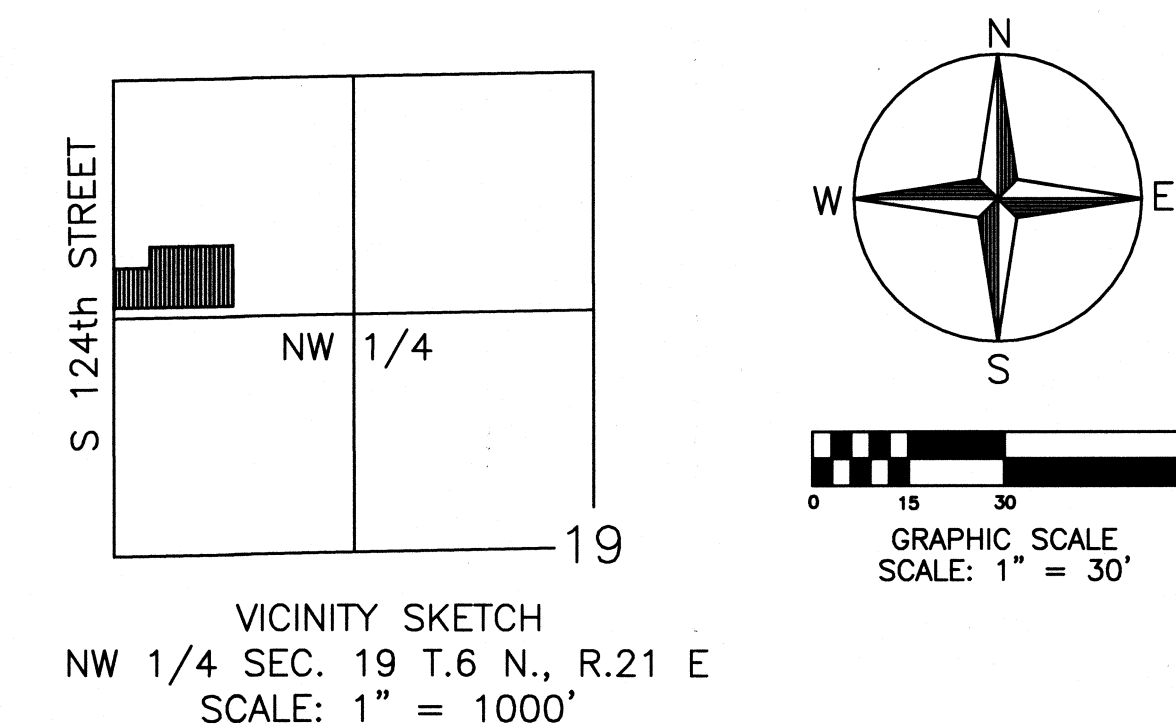

NOTES:

8" SANITARY SEWER: PVC SDR 35 ASTM D3034
RUBBER GASKET JOINT: ASTM D3212
6" LATERALS: PVC SDR35 ASTM D3034
RUBBER GASKET JOINT: ASTM D3212

MANHOLE CHIMNEY EXTERNAL SEALS: ADAPTOR, INC. "E"

ALL NEW SANITARY MANHOLES ARE 4' DIA. PRECAST CONCRETE.

DATUM - STATE PLANE COORDINATES (GRID), NAD 1927
ALL ELEVATIONS BASED ON GREENFIELD DATUM (580.61'
ADJUSTMENT TO USGS DATUM)

B.M. EXISTING SANITARY SEWER MANHOLE 01-137
RIM ELEVATION 219.18


RECORD DOCUMENT

THE LATERAL ELEVATIONS SHOWN ON THIS
RECORD DOCUMENT ARE CALCULATED AND
HAVE NOT BEEN FIELD VERIFIED. WHILE
GRAEF BELIEVES THIS INFORMATION TO BE
RELIABLE, IT CAN NOT ASSURE ITS ACCURACY.
IT IS RECOMMENDED THAT PRIOR TO UTILIZING
INFORMATION CONTAINED IN THIS RECORD
DOCUMENT THAT AN INDEPENDENT VERIFICATION
OF ITS ACCURACY BE MADE BY THE USER.

CREEKSIDE CONDOMINIUMS

CONSTRUCTION OBSERVATION BY GRAEF
GRAEF PROJECT NO. 2006-0044.23

CONSTRUCTION COMPLETED: OCTOBER, 2008

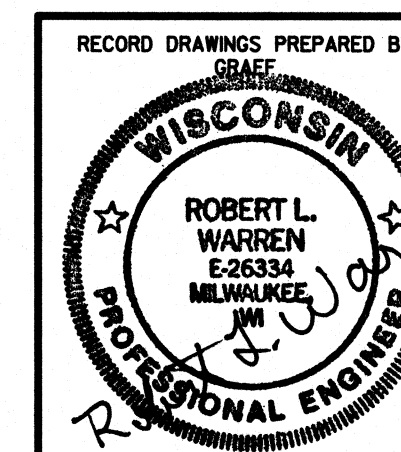

APPROVED IN ACCORDANCE WITH
SECTION 9.04 OF MMSD RULES

MANAGER, ENGINEERING DATE

IN: W. WATERFORD AVENUE

FROM: 250' NORTH OF WILDCAT COURT

TO: 580' NORTH OF WILDCAT COURT

CONTRACTOR: BCF CONSTRUCTION

DR BY: FKO

CHK BY: DFA

SCALE: 1" = 30'

CITY OF GREENFIELD
SANITARY SEWER AS-BUILT

FILE NO. A07-344

NO.	REVISIONS	BY	DATE	DESIGNED BY:	SCALE:
1	ADDED CITY'S COMMENTS	KKK	7/31/07	K. K. KLIMECK	1" = 30' HORIZ.
2	ADDED CITY'S COMMENTS	KKK	8/31/07		
3	ADDED CITY'S COMMENTS	KKK	9/26/07		
4	ADDED CITY'S COMMENTS	KKK	10/16/07		
5	ADDED CITY'S COMMENTS	KKK	10/30/07		
DRAWN BY: K. K. KLIMECK					DATE: MAY 2, 2007
CHECKED BY: K. K. KLIMECK					

**PIONEER ENGINEERING
AND SURVEYING, LLC.**

CONSULTANTS IN SUBDIVISIONS
AND COMMERCIAL DEVELOPMENTS

3902 C.T.H. "B"
JOHNSON CREEK, WI. 53038
(920) 699 - 3330 FAX: 699 - 3332

SITE PLAN FOR
CREEKSIDE CONDOMINIUMS

MUNIC. PROJ. NO.	PIONEER PROJ. NO.
CITY OF GREENFIELD	06-06
CITY ENGINEER	PIONEER SHT. NO. PAGE 1 OF 1
	PIONEER FILE NO. 06-06

C:\0606\SITE-PLAN