


OWNER:
GENESIS CONSTRUCTION
2211 S. 10TH AVENUE
SOUTH MILWAUKEE, WISCONSIN 53172
(414) 571-5011
(414) 571-5010 (FAX)

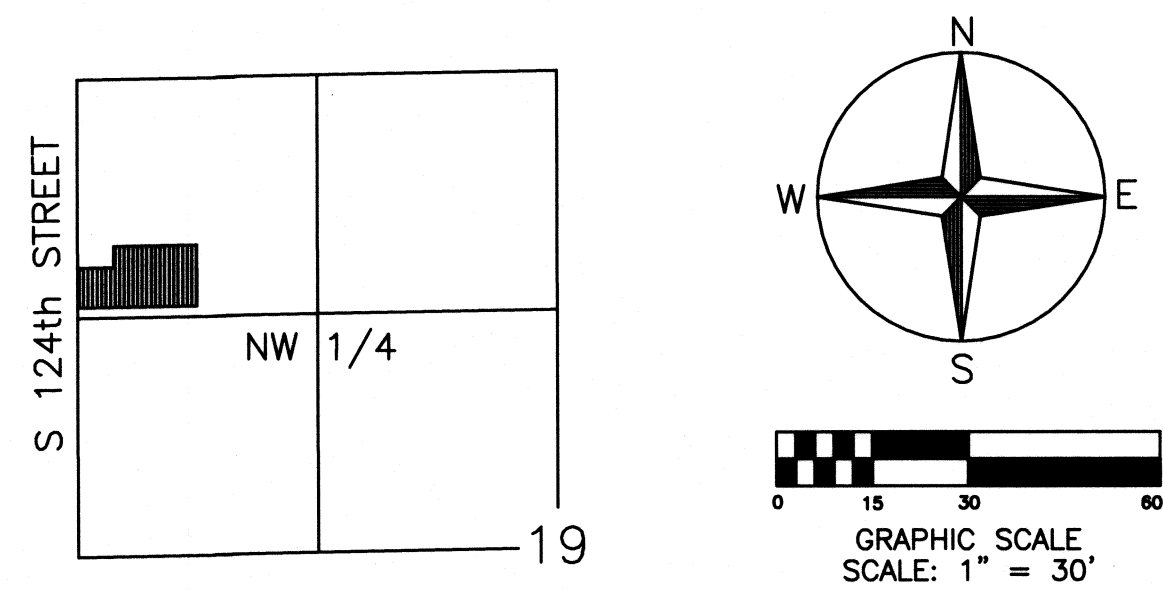

VICINITY SKETCH
NW 1/4 SEC. 19 T.6 N., R.21 E.
SCALE: 1" = 1000'

S. 124th STREET
(120' ROW)


TO BE DEDICATED FOR PUBLIC R.O.W.

5/11/2010 1:05:16 PM L:\Jobs\2006\20060044-23\CAD\Site\Record\00_STORM_044.DGN


NO.	REVISIONS	BY	DATE
1	ADDED CITY'S COMMENTS	KKK	7/31/07
2	ADDED CITY'S COMMENTS	KKK	8/31/07
3	ADDED CITY'S COMMENTS	KKK	9/26/07
4	ADDED CITY'S COMMENTS	KKK	10/16/07
5	ADDED CITY'S COMMENTS	KKK	10/30/07

DESIGNED BY:
K. K. KLIMECK
DRAWN BY:
K. K. KLIMECK
CHECKED BY:
K. K. KLIMECK

SCALE:
1" = 30' HORIZ.
DATE:
MAY 2, 2007

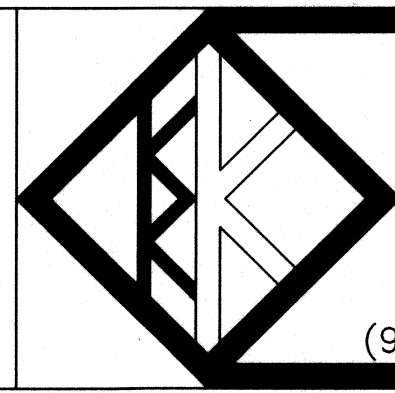

PIONEER ENGINEERING
AND SURVEYING, LLC.
CONSULTANTS IN SUBDIVISIONS
AND COMMERCIAL DEVELOPMENTS
3902 C.T.H. "B"
JOHNSON CREEK, WI. 53038
(920) 699 - 3330 FAX: 699 - 3332

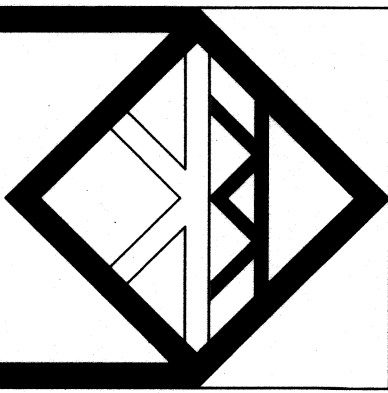

SITE PLAN FOR
CREEKSIDE CONDOMINIUMS

GRAEF PROJECT NO. 20060044.23

MUNIC. PROJ. NO.	PIONEER PROJ. NO.
CITY OF GREENFIELD	06-06
CITY ENGINEER	PIONEER SHT. NO. PAGE 1 OF 1 PIONEER FILE NO. 06-06